


MISSION INTEGRATION CENTER BUILDING 162 FIRST FLOOR PLAN

REF. DWG. COF-12162-A-101, COF12162-A-106

STAIRWAYS	
LETTER	ZONE
S1	B6
S2	B5
S3	C8

ELEVATORS	
LETTER	ZONE
E1	B5
E2	C5

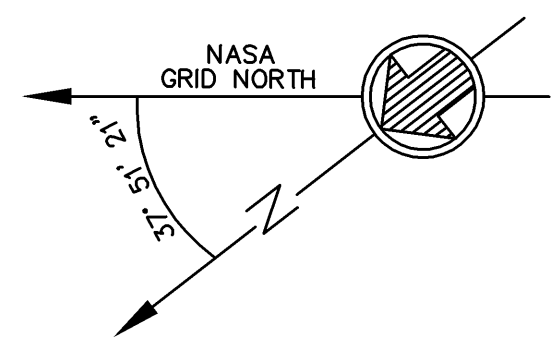

GRAPHIC SCALE
 0' 2' 4' 8' 16'
 3/32" = 1'-0"

REVISION	DESCRIPTION	DATE
E	UPDATES TO ROOMS 150 AND 151 PER FCR 2024-4999. D REV HISTORY WAS PREVIOUSLY MISSED AND ADDED WITH THIS REVISION.	PERATON AJD DH 7/15/2024
D	ADJUSTED ARCHIBUS POLYLINES	PERATON AJD DH 11/01/2023
C	ADDED AND RENUMBERED CUBICLES 103-37 AND 103-40. ADDED 140A AND 140B PER FCR 2023-4756.	PERATON AJD DH 11/21/2023
B	ADJUSTED ARCHIBUS PUBLISHING LAYERS AND ASSET TEXT PROPERTIES TO IMPROVE PRINTOUT VISIBILITY.	VPL-GESS3 AJD BK 03/03/2017
A	ADJUSTED VIDEO WALL DIMENSIONS AND ADDED DOUBLE DOOR IN ROOM 151. REVISED RM POLYLINES FOR 103 AND 150 TO AVOID DOUBLING CUBICLE SQFT IN ARCHIBUS.	VPL-GESS3 AJD BK 10/15/2016

CONTROLLED DRAWING
 THIS DRAWING IS UNDER CONFIGURATION CONTROL. REVISION BY UNAUTHORIZED PERSONNEL PROHIBITED. CONTACT RESPONSIBLE SYSTEM MANAGER FOR RELEASE.

ARCHIBUS LINKED & PUBLISHED

CHG	NUM	DESCRIPTION	APP/DATE
REVISIONS			
CAD DRAWING - DO NOT REVISE MANUALLY			

	DRAWING / DESIGN STATUS:		
	RECORD DRAWING		
	DRAWING MANAGEMENT		
	SYSTEM: FLO	SUB-SYS: FACILITY:	CONFIG: CFG
NASA APPROVALS			
DR:	DES:		
D.ENG:	PROJ. MGR:		
RELEASE APPROVAL: Kershaw, Bradley	DATE: 20240718		
RELEASE APPROVAL: Munro, Ryan	DATE: 20240718		
RELEASE APPROVAL:	DATE:		
APPROVED: PRL	APPROVAL DATE: 07/16/2014	RELEASE STATUS: RELEASE	

NATIONAL AERONAUTICS AND SPACE ADMINISTRATION JOHN H. GLENN RESEARCH CENTER LEWIS FIELD & ARMSTRONG TEST FACILITY, OHIO			
MISSION INTEGRATION CENTER BUILDING 0162			
FIRST FLOOR PLAN			
SIZE: BLDG/SYS	PROJECT ID	DISCP	TYP SEQ
CD 0162 - FLOORPLN - A- 101			
AREA:	SHEET	01	OF 01
UNITS: ENGLISH	SOFTWARE: AUTOCAD 2010	REVISION	VER
SCALE: 3/32" = 1'-0"	OFFICIAL DATE: 07/16/2014	E	0

PROPERTY OF UNITED STATES GOVERNMENT - FOR OFFICIAL USE ONLY. Do not Remove This Notice. Property destroy document when no longer needed.