
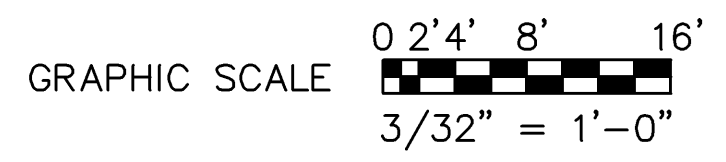


# MISSION INTEGRATION CENTER BUILDING 162 THIRD FLOOR PLAN

REF. DWG. COF12162-A-103, COF12162-A-106

STAIRWAYS	
LETTER	ZONE
S2	B5
S3	C8
S4	C6
S5	C4

ELEVATORS	
LETTER	ZONE
E1	B5
E2	C5

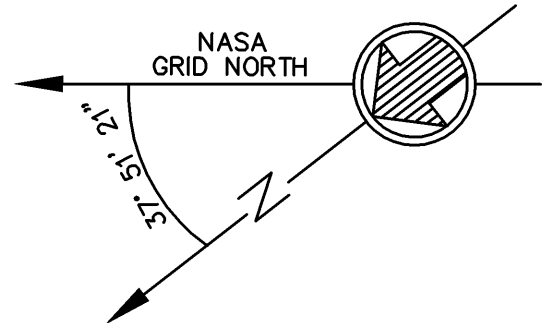

D	MODIFICATIONS TO ROOMS 318, 319, 346, AND 347 PER PCR 2024-4999	PERATON AJD DH 7/15/2024
C	ADDED CUBICLES 321-41 THROUGH 321-43. RE-NUMBERED CUBICLES 321-41 THROUGH 321-47.	PERATON AJD DH 02/21/2023
B	ADJUSTED ARCHIBUS PUBLISHING LAYERS AND ASSET TEXT PROPERTIES TO IMPROVE PRINTOUT VISIBILITY.	VPL-GESS3 AJD BK 03/06/2017
A	REVISED RM POLYLINES FOR 305, 306, 321, 326, 332 AND 335 TO AVOID DOUBLING CUBICLE SQFT IN ARCHIBUS.	VPL-GESS3 AJD BK 10/15/2016

**CONTROLLED DRAWING**  
THIS DRAWING IS UNDER CONFIGURATION CONTROL  
REVISION BY UNAUTHORIZED PERSONNEL PROHIBITED  
CONTACT RESPONSIBLE SYSTEM MANAGER FOR RELEASE

ARCHIBUS LINKED & PUBLISHED

CHG NUM	DESCRIPTION	APP/DATE
<b>REVISIONS</b>		
<b>CAD DRAWING - DO NOT REVISE MANUALLY</b>		

	<b>DRAWING / DESIGN STATUS:</b>	
	<b>RECORD DRAWING</b>	
	<b>DRAWING MANAGEMENT</b>	
	SYSTEM: FLOR	SUB-SYS: FACILITY: CONFG: CFG
<b>NASA APPROVALS</b>		
DR:	DES:	
D.ENG:	PROJ. MGR:	
RELEASE APPROVAL:	DATE:	
Kershaw, Bradley	20240718	
RELEASE APPROVAL:	DATE:	
Munro, Ryan	20240718	
RELEASE APPROVAL:	DATE:	
SMK	DESIGNED	CHECKED
APPROVED:	APPROVAL DATE:	
PRL	10/08/2014	
RELEASE STATUS:	RELEASE	

<b>NATIONAL AERONAUTICS AND SPACE ADMINISTRATION</b> JOHN H. GLENN RESEARCH CENTER LEWIS FIELD & ARMSTRONG TEST FACILITY, OHIO			
MISSION INTEGRATION CENTER BUILDING 0162			
THIRD FLOOR PLAN			
SIZE	BLDG/SYS	PROJECT ID	DISCP   TYP SEQ
<b>CD 0162 - FLOORPLN - A- 103</b>		SHEET <b>01</b> OF <b>01</b>	
UNITS: ENGLISH	SOFTWARE: AUTOCAD 2010	REVISION	VER
SCALE: 3/32" = 1'-0"	OFFICIAL DATE: 10/08/2014	<b>D</b>	0

PROPERTY OF UNITED STATES GOVERNMENT - FOR OFFICIAL USE ONLY. Do not Remove This Notice. Property destroy document when no longer needed.